
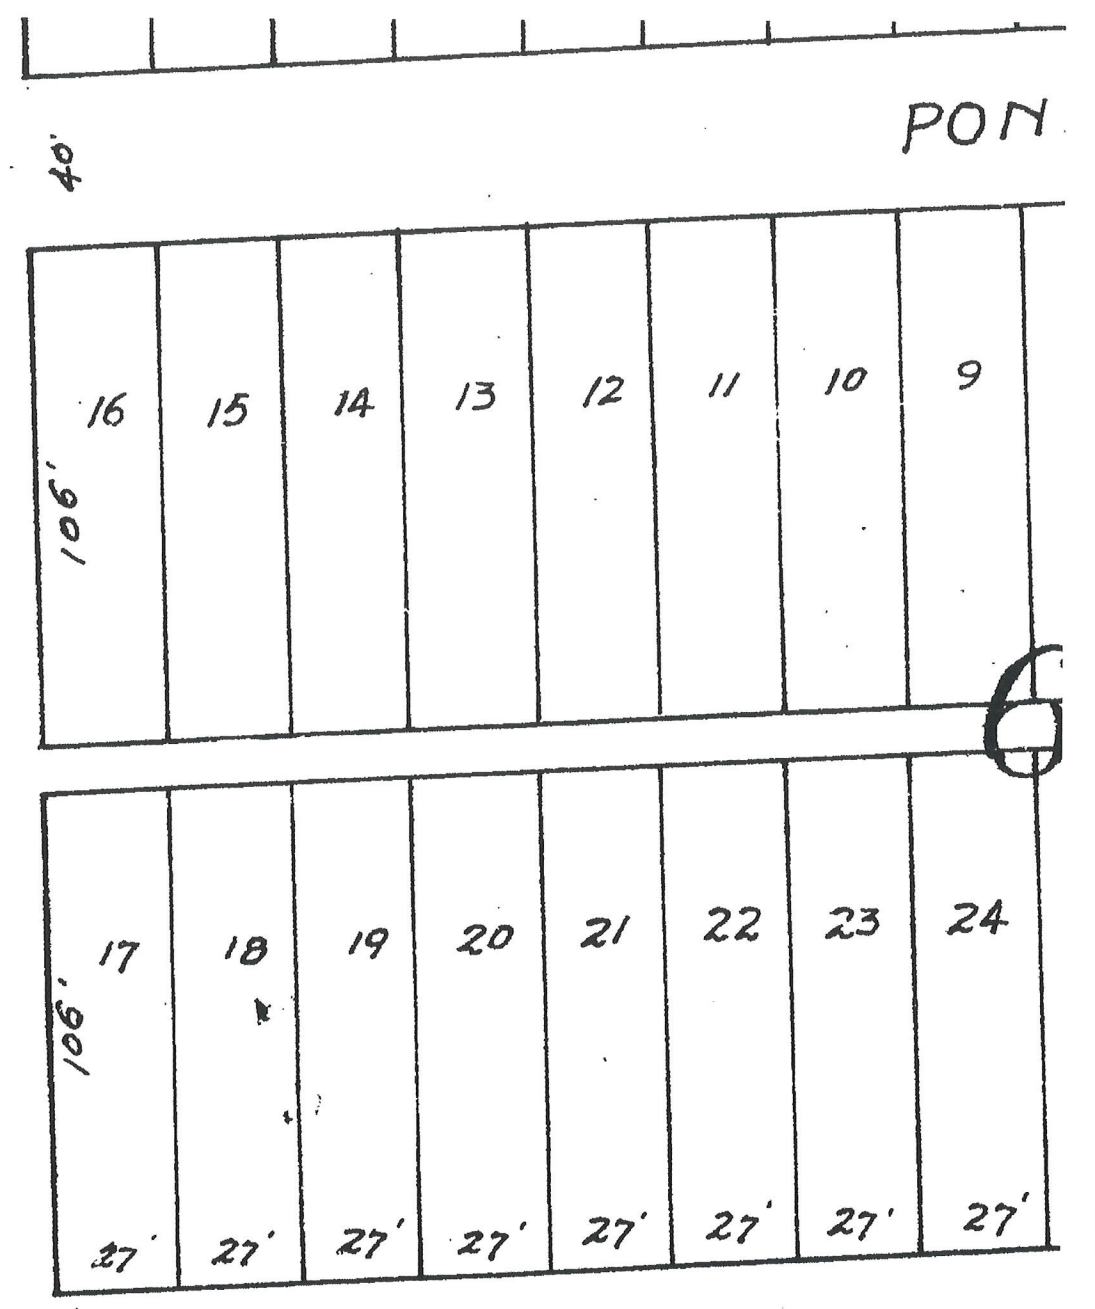


"MAP EXHIBIT"
(MEADOWVIEW)

SCALE: 1" = 40'

= PLAT OF MEADOWVIEW
PB B, PAGE 233

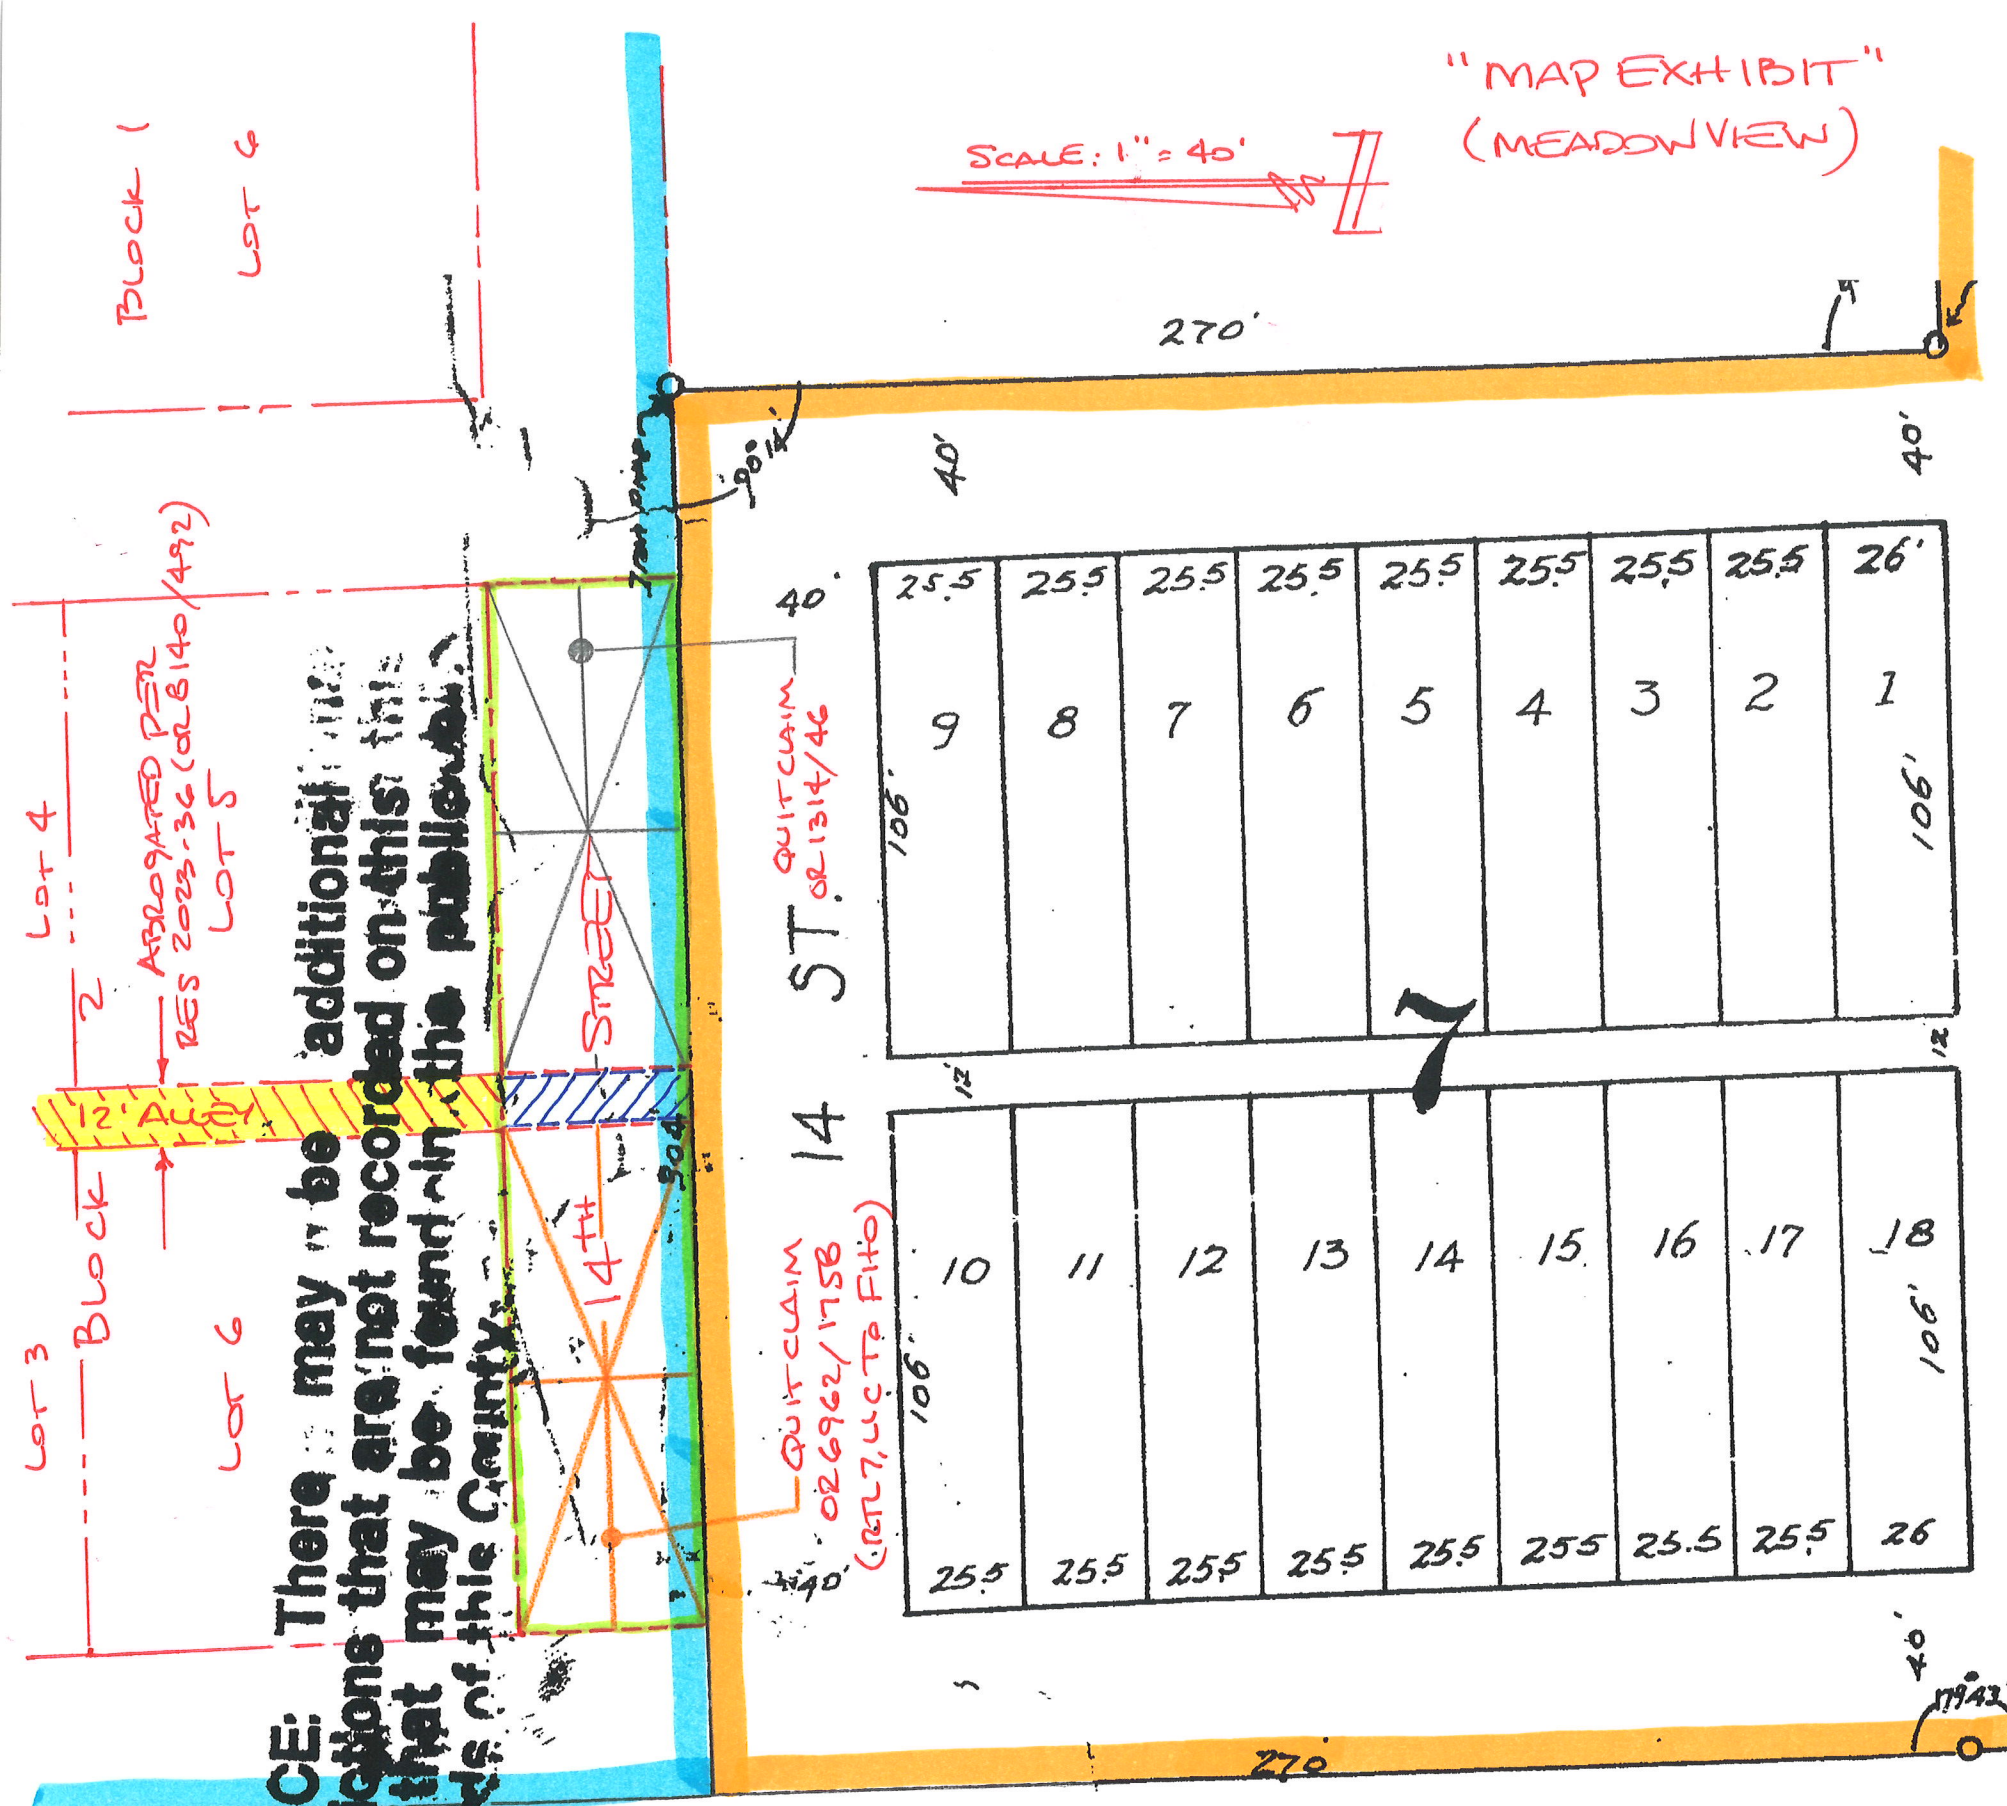

NOTE: There may be additional
revisions that are not recorded on this
that may be found in the public
records of this County.

= PLAT OF HILLVIEW ADDITION
PB A, PAGE 192

MARK-UP OF
SEE SKETCH OF LEGAL DESCRIPTION
BY ROGERS ENGINEERING
DATED 2-1-2023

= LIMITS OF
ABROGATION
PER RES 2023-36
OR 8140/492

SCALE: 1" = 87' +/-

"MAP EXHIBIT"
(HILLVIEW ADDITION)

APR 23-45262 RKR
2-14-2024
SHEET 2 of 2

