



REAR




STREET SIDE

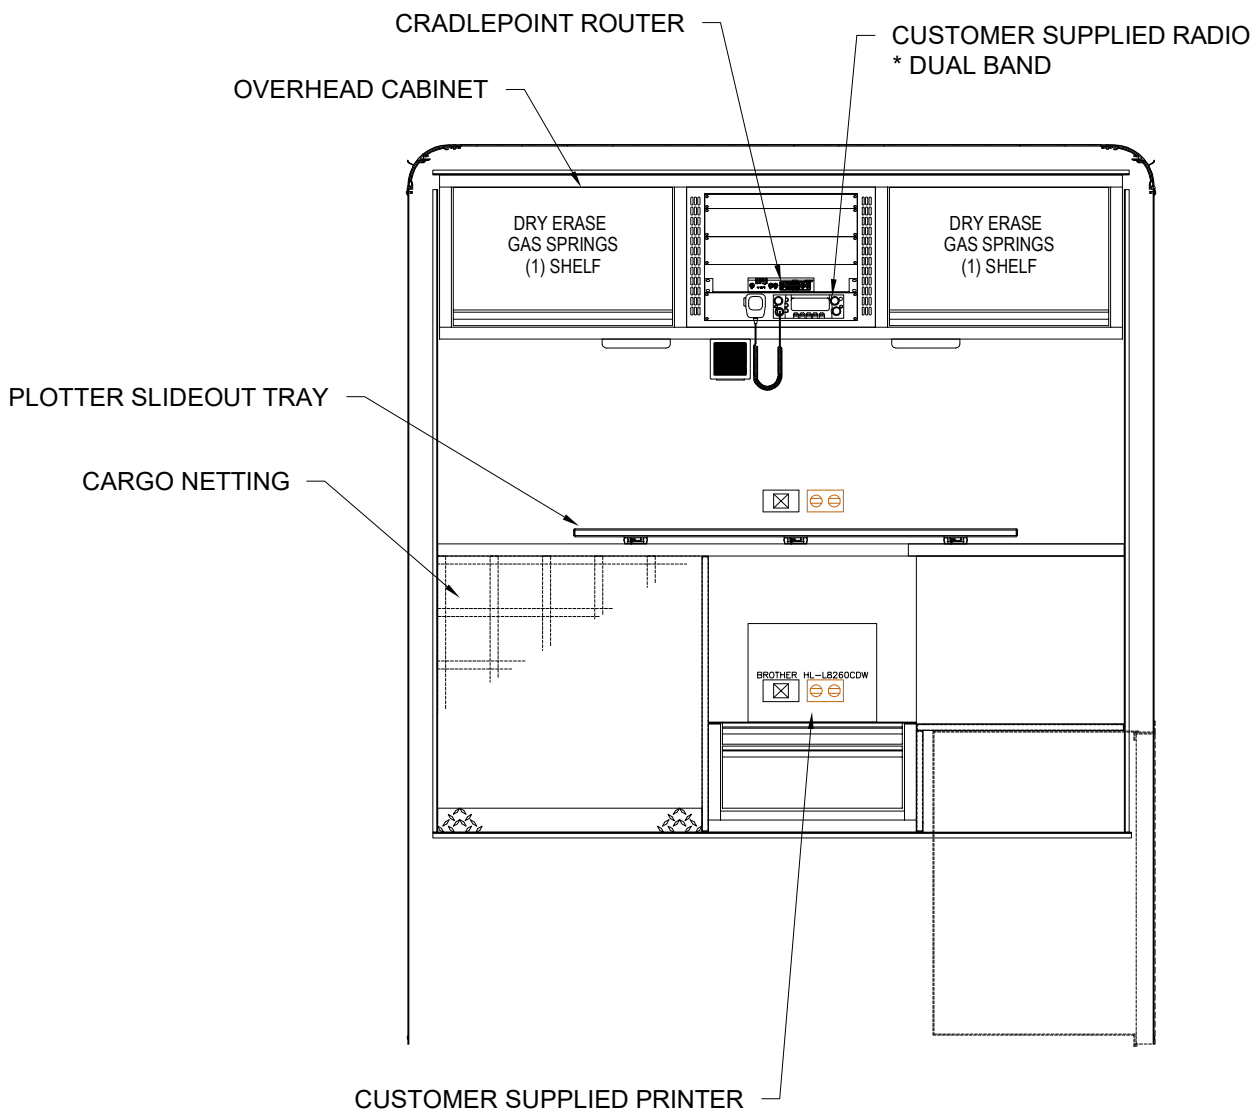

FRONT

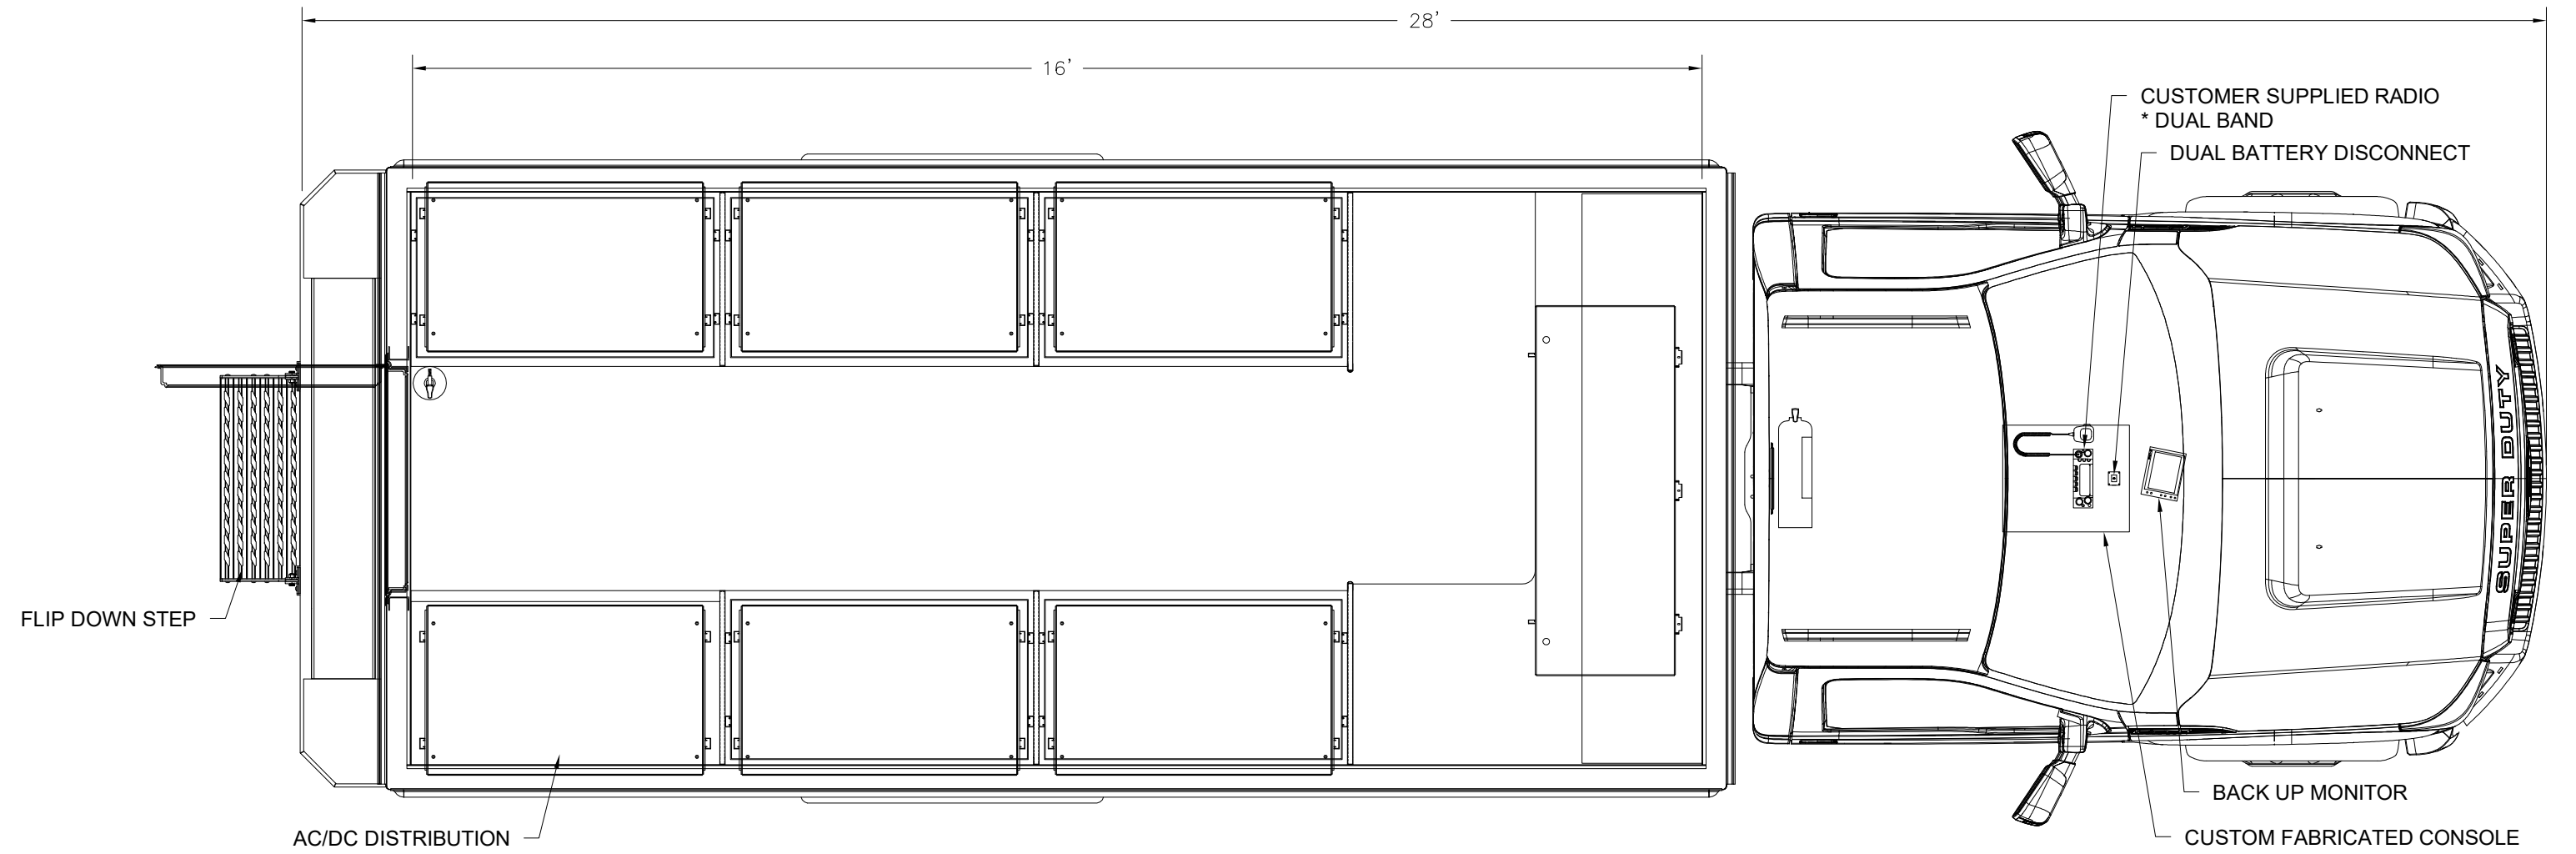

PLAN

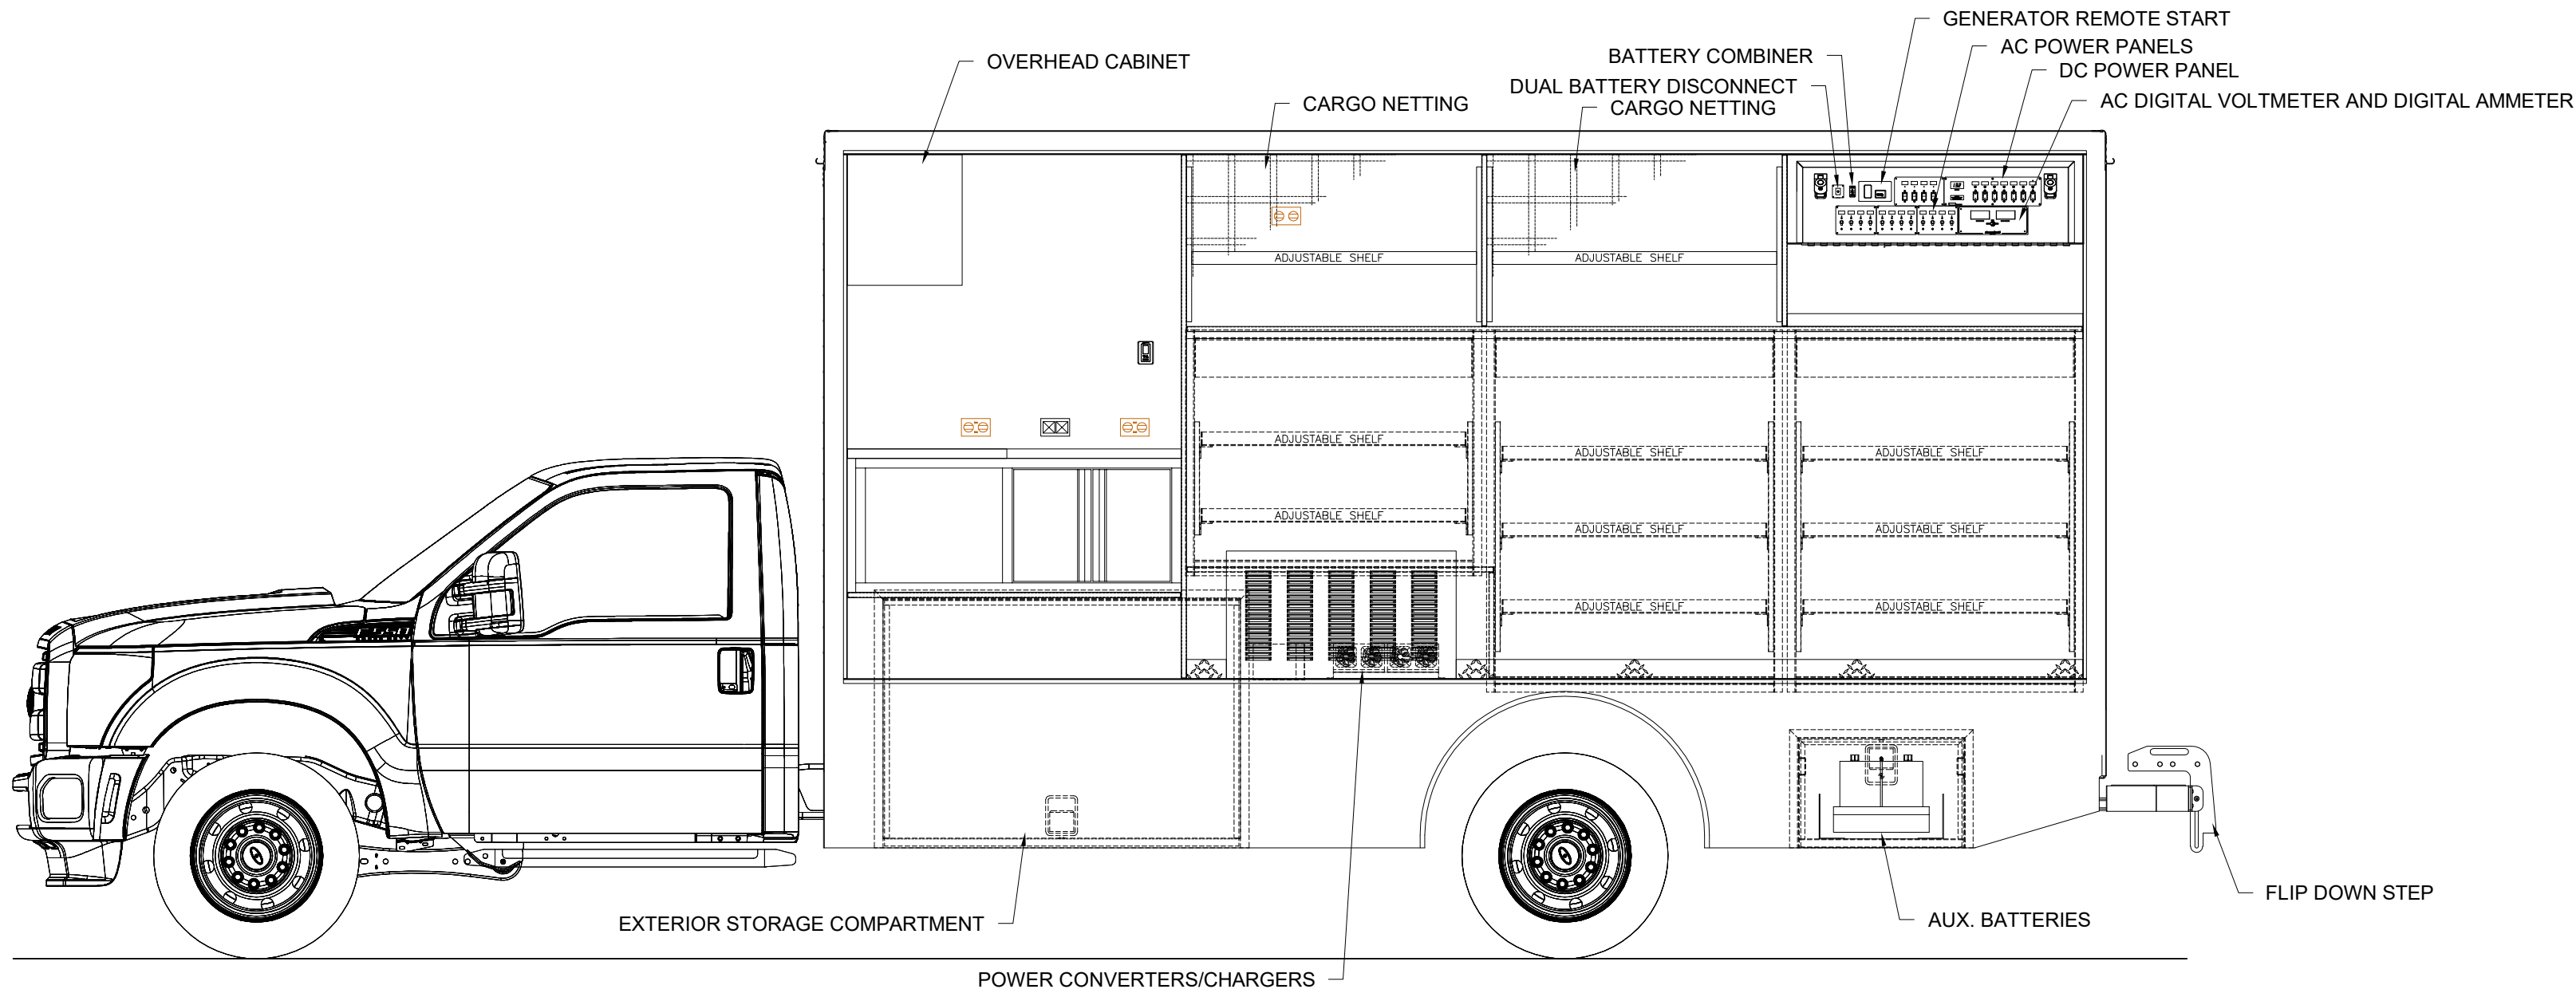

CURB SIDE

	LED CEILING LIGHT (WHITE)		HDMI PORT		TPD INTERIOR INTEL-I-TOUCH PAD		ALARM SYSTEM CONTROL
	LED CEILING LIGHT (WHITE, RED OR BLUE)		RJ-45 NETWORK JACK		TPS EXTERIOR INTEL-I-TOUCH PAD		WATER/WASTE TANK LEVEL MONITOR
	ON DURING REDUCED MODE		RJ-11 TELEPHONE JACK		SURVEILLANCE CAMERA		CO/SMOKE DETECTOR
	120 VAC (ELECTRONICS/DEDICATED)		TV ANTENNA		EXTERIOR 120 VAC G.F.I.		SPEAKER
	120 VAC (NON-DEDICATED)		SPARE PLATE		AC THERMOSTAT		BACK-UP CAMERA
	120 VAC (HOT/AUTO EJECT/SHORE)		SWITCH		ESPAR FURNACE THERMOSTAT		PERIMETER CAMERA
	OUTLET IDENTIFICATION COLOR		MICROPHONE				

SOME ITEMS SHOWN MAY BE CUSTOMER SUPPLIED OR OPTIONAL. REFER TO SPECIFICATIONS FOR DETAILS.

THIS DRAWING AND THE INFORMATION THEREON IS THE EXCLUSIVE PROPERTY OF LDV, INC. AND IS TO BE USED SOLELY FOR DEVELOPMENT AND MANUFACTURE OF THE PRODUCT SHOWN. ALL RIGHTS RESERVED IN U.S. COPYRIGHT LAW.

REVISIONS			
NO.	DESCRIPTION	DATE	BY
1			
2			
3			
4			
5			
6			
7			

CONTRA COSTA COUNTY SHERIFF'S (CA)
623281

DRAWN BY C. COULTER	DATE 05.11.21	SCALE 1/2" = 1'-0"
PROJECT MGR. D. HINTZ	DATE	DWG. TYPE: X
DRAWING AS BUILT SALES		